


THESE RECORD DRAWINGS HAVE BEEN PREPARED BASED ON INFORMATION SUBMITTED, IN PART, BY OTHERS. WHILE THIS INFORMATION IS BELIEVED TO BE RELIABLE, E & A CONSULTING GROUP, INC. IS NOT RESPONSIBLE FOR ITS ACCURACY NOR FOR ERRORS OR OMISSIONS WHICH MAY HAVE BEEN INCORPORATED AS A RESULT OF SUCH INFORMATION.

E & A CONSULTING GROUP, INC.  
 Engineering • Planning • Environmental & Field Services  
 19000 14th Avenue Road, Suite 100 • Omaha, NE 68154  
 Phone: 402.226.2500  
 www.eagsg.com

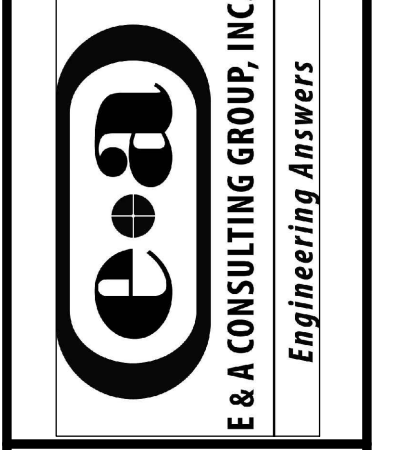

ANCHOR VIEW - LOTS 1-4, 33-38, 63-81, 104-114, R1 1-69  
 SANITARY SEWER - SECTION I  
 SID 6'10" - DOUGLAS COUNTY, NEBRASKA

# SEWER STUB MAP

Proj No: P2020-164-000  
 Date: 11/28/2022  
 Drawn By: BJS