




THESE RECORD DRAWINGS HAVE BEEN PREPARED BASED ON INFORMATION SUBMITTED, IN PART, BY OTHERS. WHILE THIS INFORMATION IS BELIEVED TO BE RELIABLE, E & A CONSULTING GROUP, INC. IS NOT RESPONSIBLE FOR ITS ACCURACY NOR FOR ERRORS OR OMISSIONS WHICH MAY HAVE BEEN INCORPORATED AS A RESULT OF SUCH INFORMATION.

**E & A CONSULTING GROUP, INC.**  
 Engineering • Planning • Environmental & Field Services  
 19300 Judd Valley Road, Suite 100 • Omaha, NE 68194  
 Phone: 402.226.2266  
 www.eagroup.com

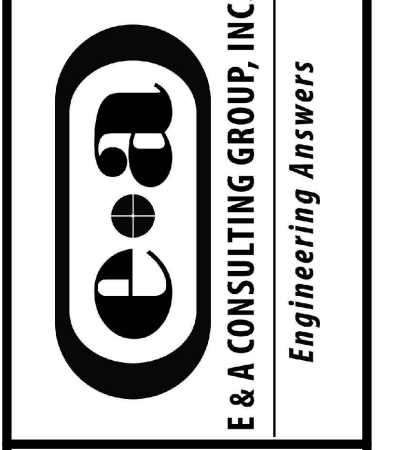

**BELTERRA - LOTS 97 THRU 212**  
**SANITARY SEWER - SECTION II**  
**SID 344 - SARPY COUNTY, NEBRASKA**

**SEWER STUB MAP**

Proj No: P2017.550.000  
 Date: 02/07/2022  
 Drawn By: BJS

