


THESE RECORD DRAWINGS HAVE BEEN PREPARED BASED ON INFORMATION SUBMITTED, IN PART, BY OTHERS. WHILE THIS INFORMATION IS BELIEVED TO BE RELIABLE, E & A CONSULTING GROUP, INC. IS NOT RESPONSIBLE FOR ITS ACCURACY NOR FOR ERRORS OR OMISSIONS WHICH MAY HAVE BEEN INCORPORATED AS A RESULT OF SUCH INFORMATION.

E & A CONSULTING GROUP, INC.
 Engineering • Planning • Environmental & Field Services
 10900 Main Highway Road, Suite 100 • Omaha, NE 68154
 Phone: 402.426.2822 • Fax: 402.426.2828
 www.eagcg.com

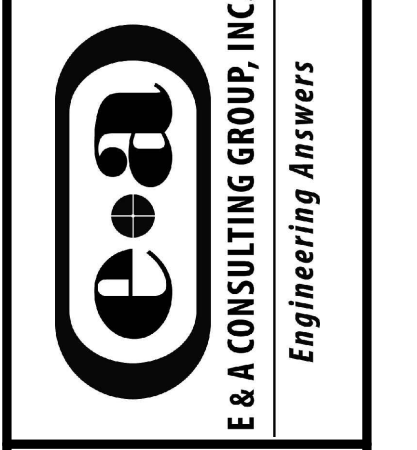

COVENTRY WOOD - LOTS 1 - 174
SANITARY SEWER - SECTION I
SID 630 DOUGLAS COUNTY, NEBRASKA

SEWER STUB MAP

Proj No: P2022-076-000
 Date: 09/05/2024
 Drawn By: JTT