


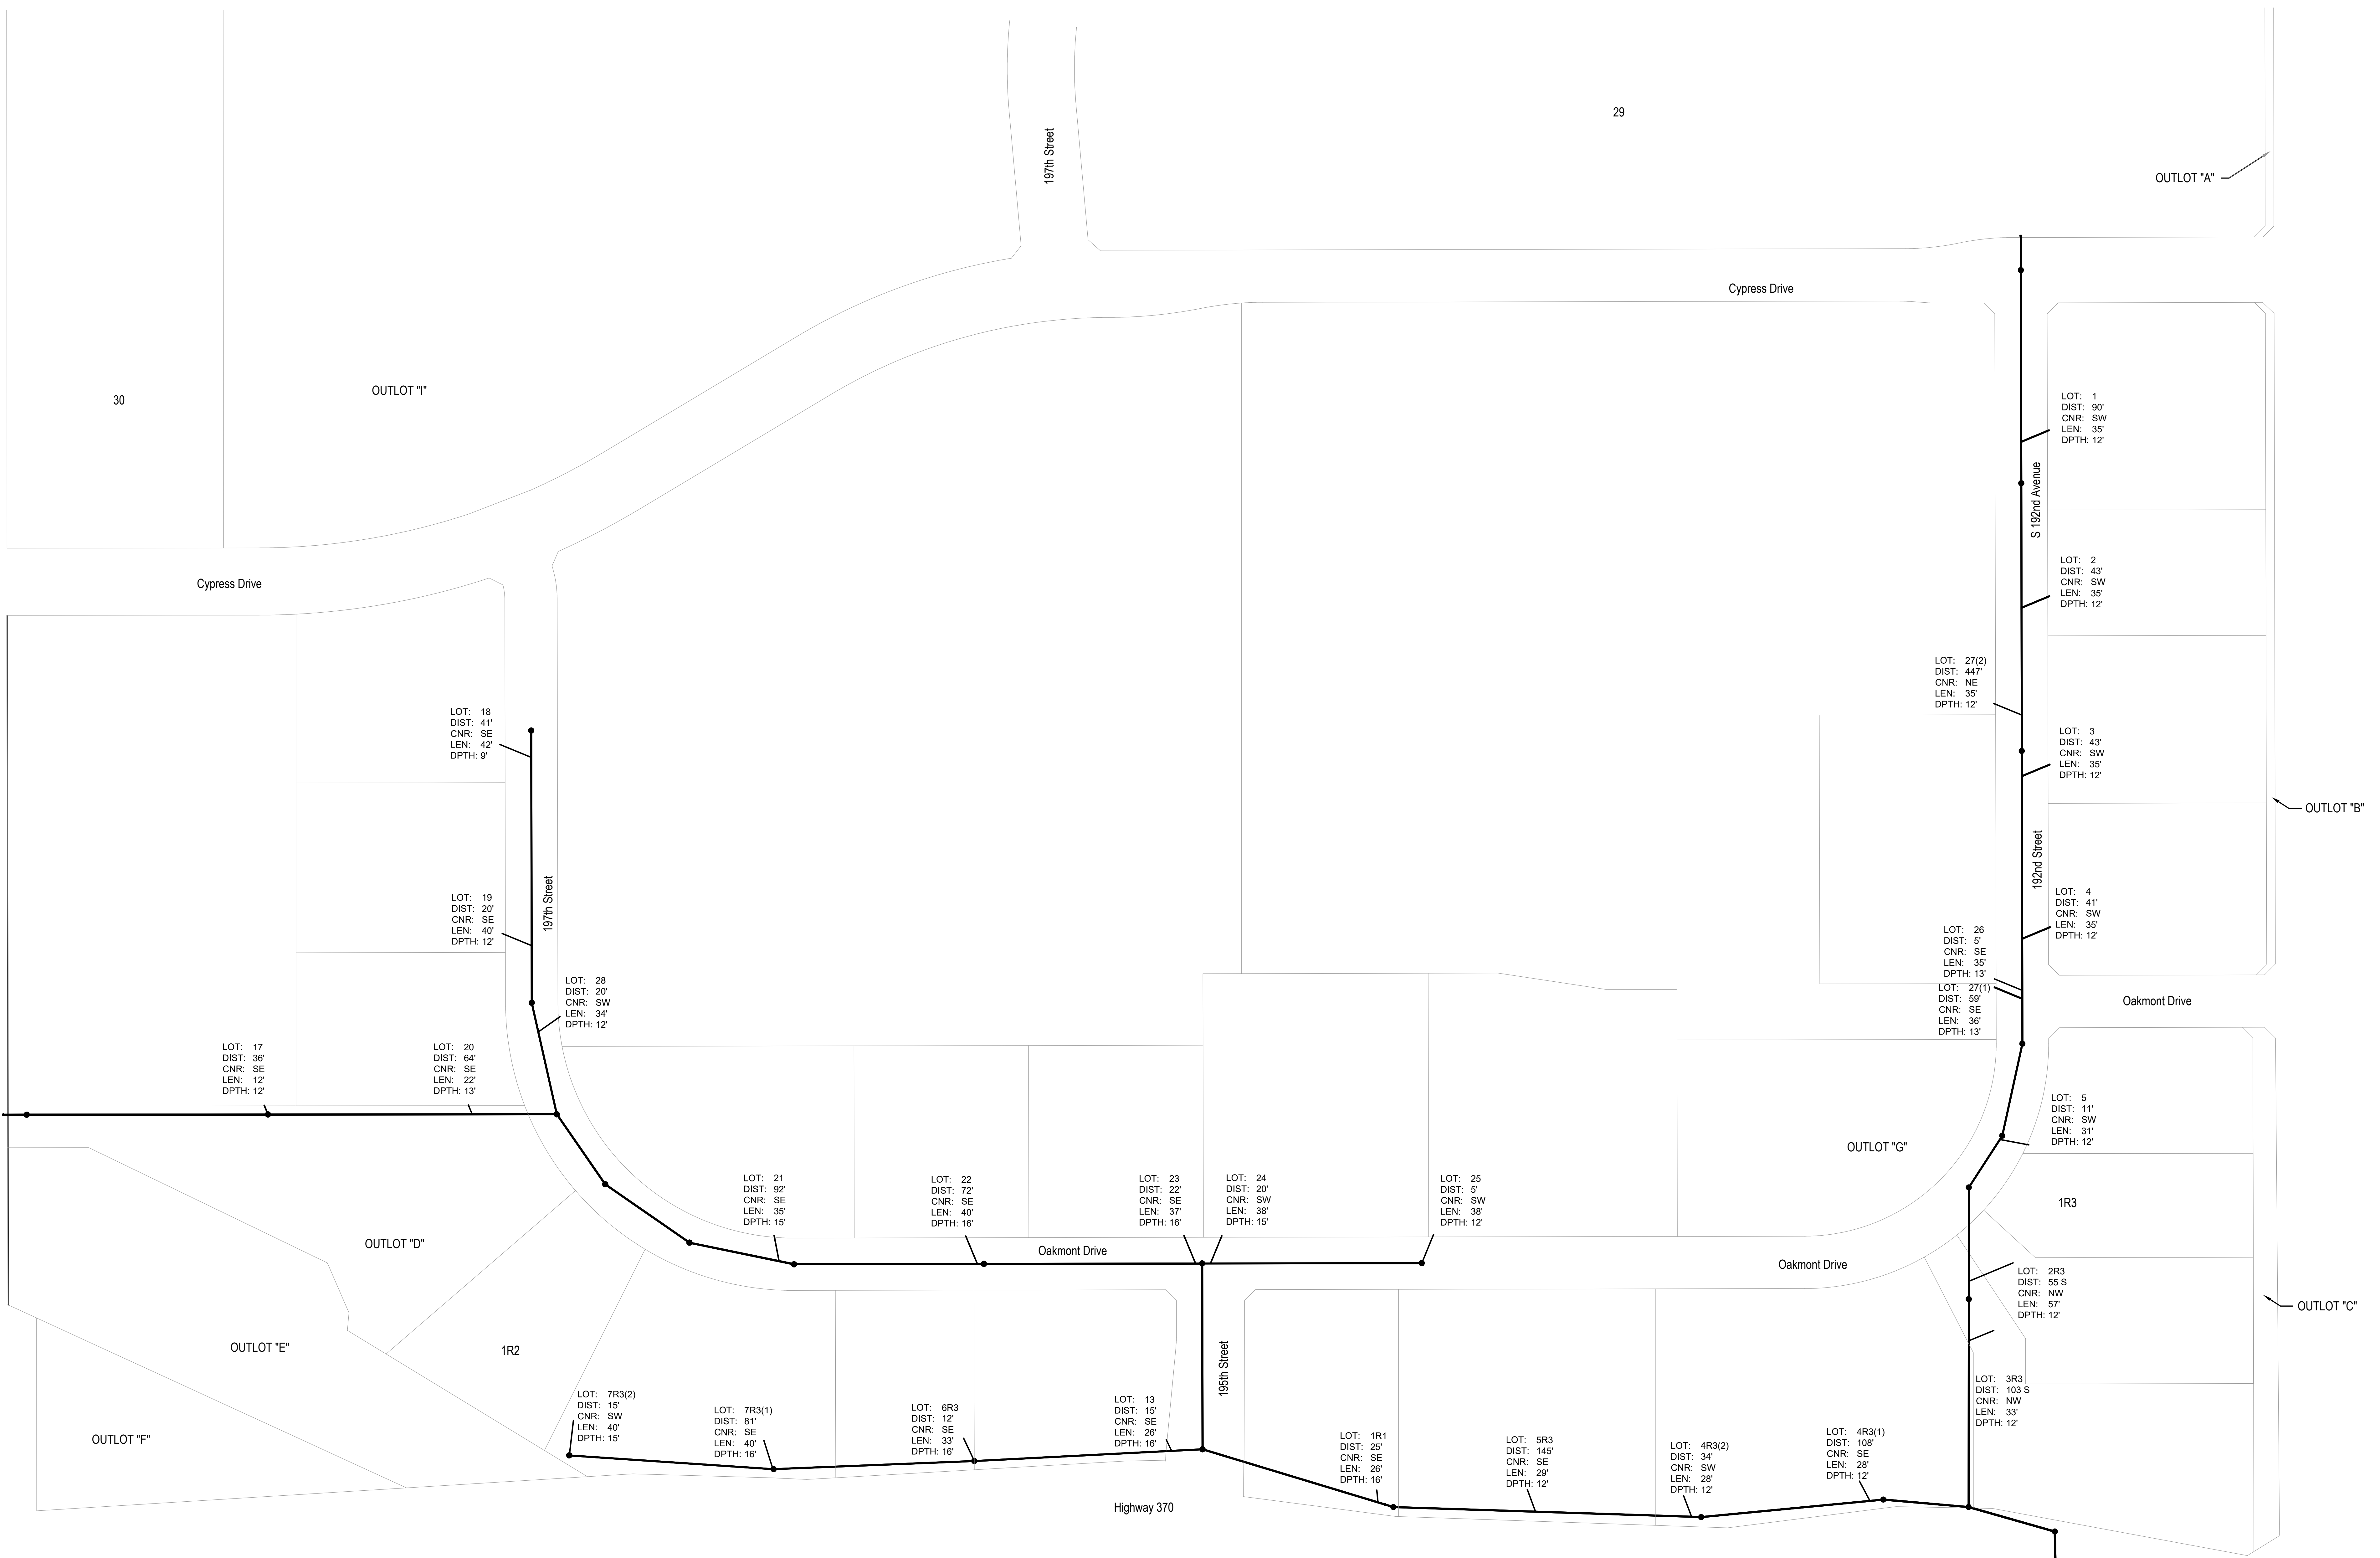

THESE RECORD DRAWINGS HAVE BEEN PREPARED BASED ON INFORMATION SUBMITTED, IN PART, BY OTHERS. WHILE THIS INFORMATION IS BELIEVED TO BE RELIABLE, E & A CONSULTING GROUP, INC. IS NOT RESPONSIBLE FOR ITS ACCURACY NOR FOR ERRORS OR OMISSIONS WHICH MAY HAVE BEEN INCORPORATED AS A RESULT OF SUCH INFORMATION.



E & A CONSULTING GROUP, INC.
 Engineering • Planning • Environmental & Field Services
 10900 Jahn Valley Road, Suite 100 • Omaha, NE 68154
 Phone: 402.282.2266
 www.eagc.com



GREYNA LANDING -
 LOTS 1 - 5, 2R3 - 5R3, 1R1, 13, 6R3 - 7R3, 17 - 28
 SANITARY SEWER - SECTION I & II
 SID 359 - SARPY COUNTY, NEBRASKA

SEWER STUB MAP

Proj No: 2020-229-000
 Date: 05/07/2024
 Drawn By: JTT