


THESE RECORD DRAWINGS HAVE BEEN PREPARED BASED ON INFORMATION SUBMITTED, IN PART, BY OTHERS. WHILE THIS INFORMATION IS BELIEVED TO BE RELIABLE, E & A CONSULTING GROUP, INC. IS NOT RESPONSIBLE FOR ITS ACCURACY NOR FOR ERRORS OR OMISSIONS WHICH MAY HAVE BEEN INCORPORATED AS A RESULT OF SUCH INFORMATION.

E & A CONSULTING GROUP, INC.
 Engineering • Planning • Environmental & Field Services
 10900 Judd Valley Road, Suite 100 • Omaha, NE 68154
 Phone: 402.232.2222
 www.eagroup.com

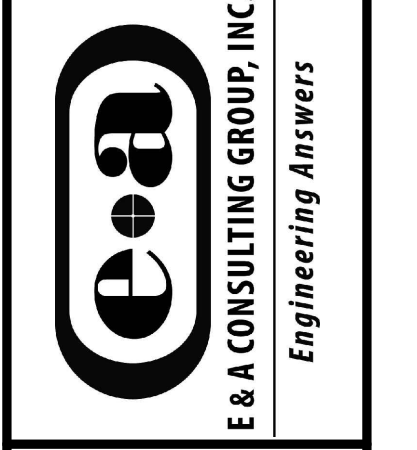

LINCOLN RIDGE - LOTS 1 - 99
SANITARY SEWER - SECTION I
SID 356 - SARPY COUNTY, NEBRASKA

SEWER STUB MAP

Proj No: E2017290.000
 Date: 05/26/2022
 Drawn By: BJS

8/15/2022 10:52 AM J:\Projects\Draws\2022\2022-05-26\2022-05-26-000.dwg