


THESE RECORD DRAWINGS HAVE BEEN PREPARED BASED ON INFORMATION SUBMITTED, IN PART, BY OTHERS. WHILE THIS INFORMATION IS BELIEVED TO BE RELIABLE, E & A CONSULTING GROUP, INC. IS NOT RESPONSIBLE FOR ITS ACCURACY NOR FOR ERRORS OR OMISSIONS WHICH MAY HAVE BEEN INCORPORATED AS A RESULT OF SUCH INFORMATION.

E & A CONSULTING GROUP, INC.
 Engineering • Planning • Environmental & Field Services
 10900 Judd Valley Road, Suite 100 • Omaha, NE 68154
 Phone: 402.232.2200
 www.eagroup.com

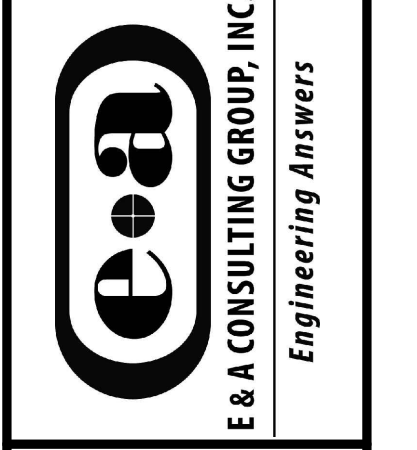

MIRABEL - LOTS 1 - 82
SANITARY SEWER - SECTION I
SID 347 - SARPY COUNTY, NEBRASKA

SEWER STUB MAP

Proj No: P2021.129.000
 Date: 02/01/2023
 Drawn By: ARH