




THESE RECORD DRAWINGS HAVE BEEN PREPARED BASED ON INFORMATION SUBMITTED, IN PART, BY OTHERS. WHILE THIS INFORMATION IS BELIEVED TO BE RELIABLE, E & A CONSULTING GROUP, INC. IS NOT RESPONSIBLE FOR ITS ACCURACY NOR FOR ERRORS OR OMISSIONS WHICH MAY HAVE BEEN INCORPORATED AS A RESULT OF SUCH INFORMATION.

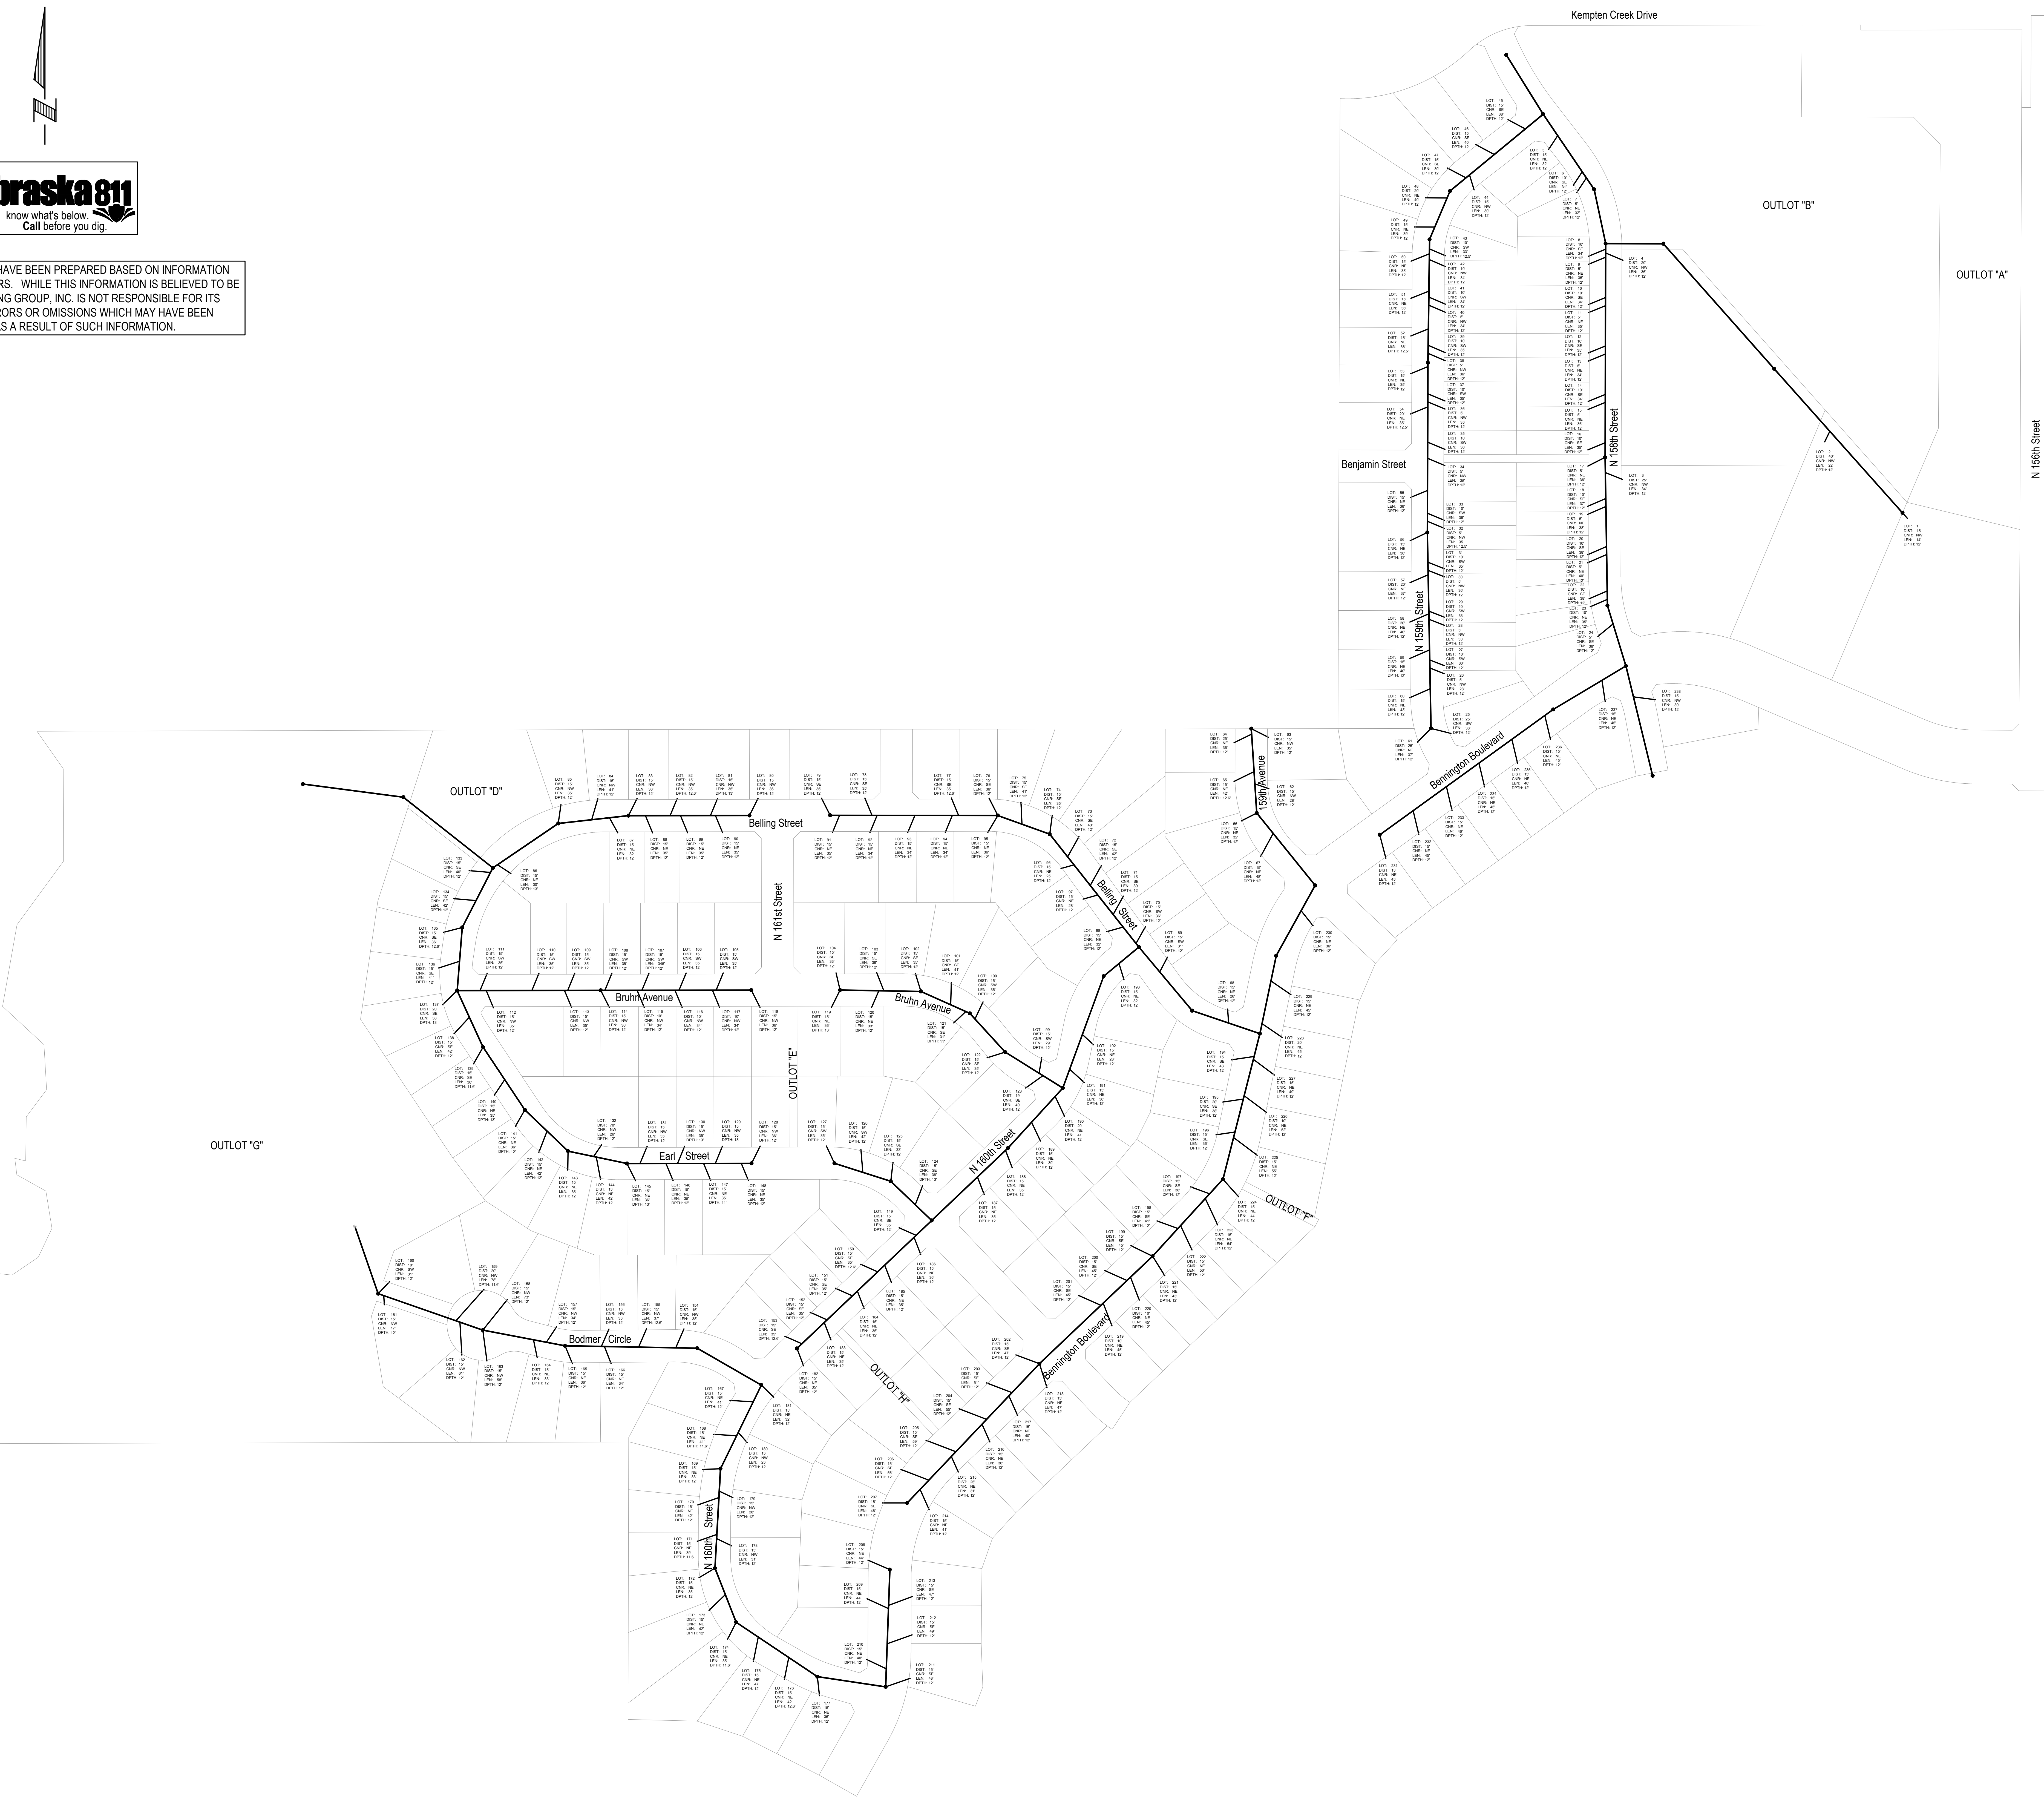

Proj No: P2021.321.000
Date: 09/06/2024
Drawn By: JTT

SEWER STUB MAP

MORGAN RIDGE - LOTS 1 - 238
SANITARY SEWER - SECTION I
SID 623 - DOUGLAS COUNTY, NEBRASKA



E & A CONSULTING GROUP, INC.
Engineering • Planning • Environmental & Field Services
10900 JAWA Way, Suite 100 • Omaha, NE 68154
Phone: (402) 552-2200
www.eagc.com

8/15/2024 1:58 AM - JTTed (Project) Sanitary Sewer Stub Map.dwg