





THESE RECORD DRAWINGS HAVE BEEN PREPARED BASED ON INFORMATION SUBMITTED, IN PART, BY OTHERS. WHILE THIS INFORMATION IS BELIEVED TO BE RELIABLE, E & A CONSULTING GROUP, INC. IS NOT RESPONSIBLE FOR ITS ACCURACY NOR FOR ERRORS OR OMISSIONS WHICH MAY HAVE BEEN INCORPORATED AS A RESULT OF SUCH INFORMATION.

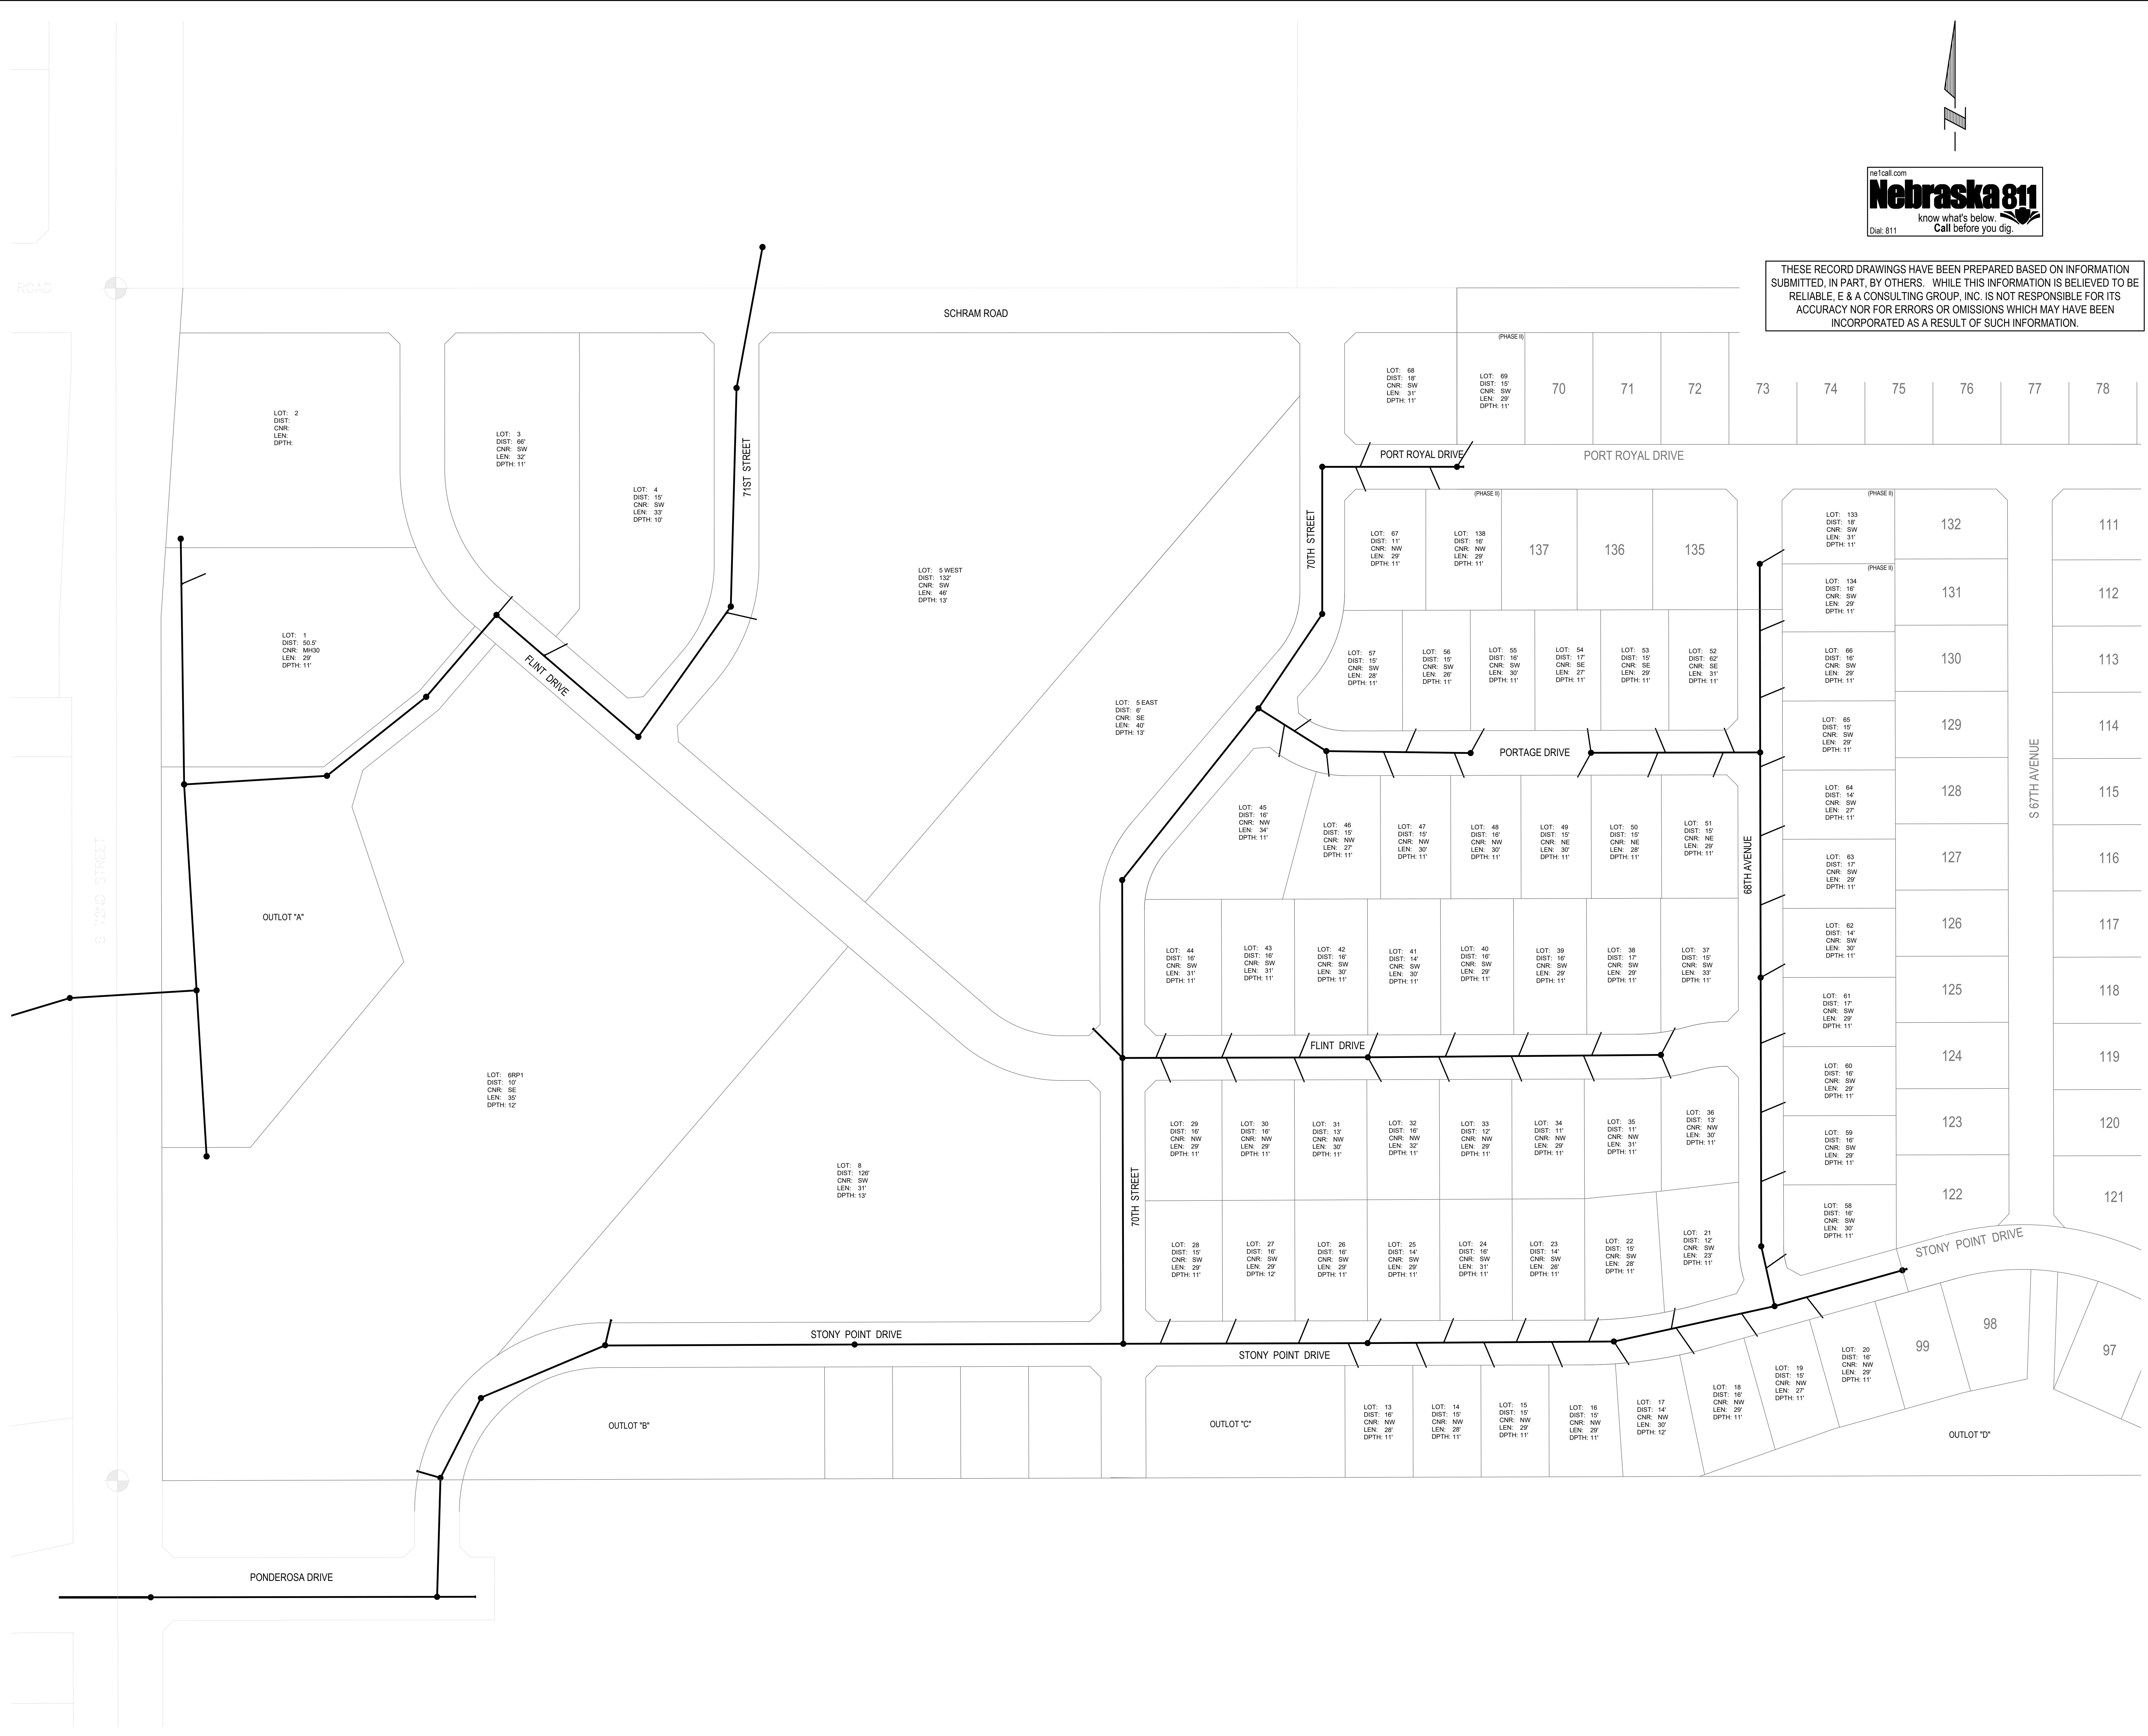

E & A CONSULTING GROUP, INC.
Engineering • Planning • Environmental & Field Services
10000 14th Street, Suite 100 • Omaha, NE 68154
Phone: 402.222.2222
www.eagroup.com

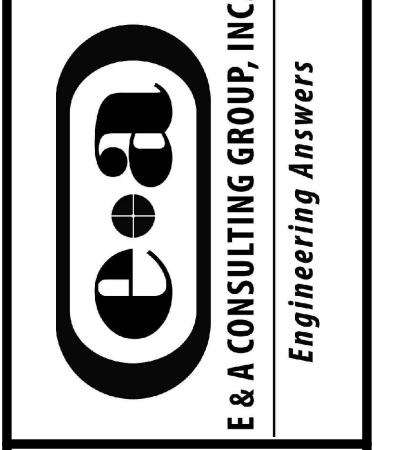

SEVENTY-TWO PLACE - LOTS 1-5,
6RP1, 8, 13-69, 133-134, 138
SANITARY SEWER - SECTION I
SID 350 - SARPY COUNTY, NEBRASKA

SEWER STUB MAP

Proj No: P2018-228-000
Date: 08/04/2022
Drawn By: BJS