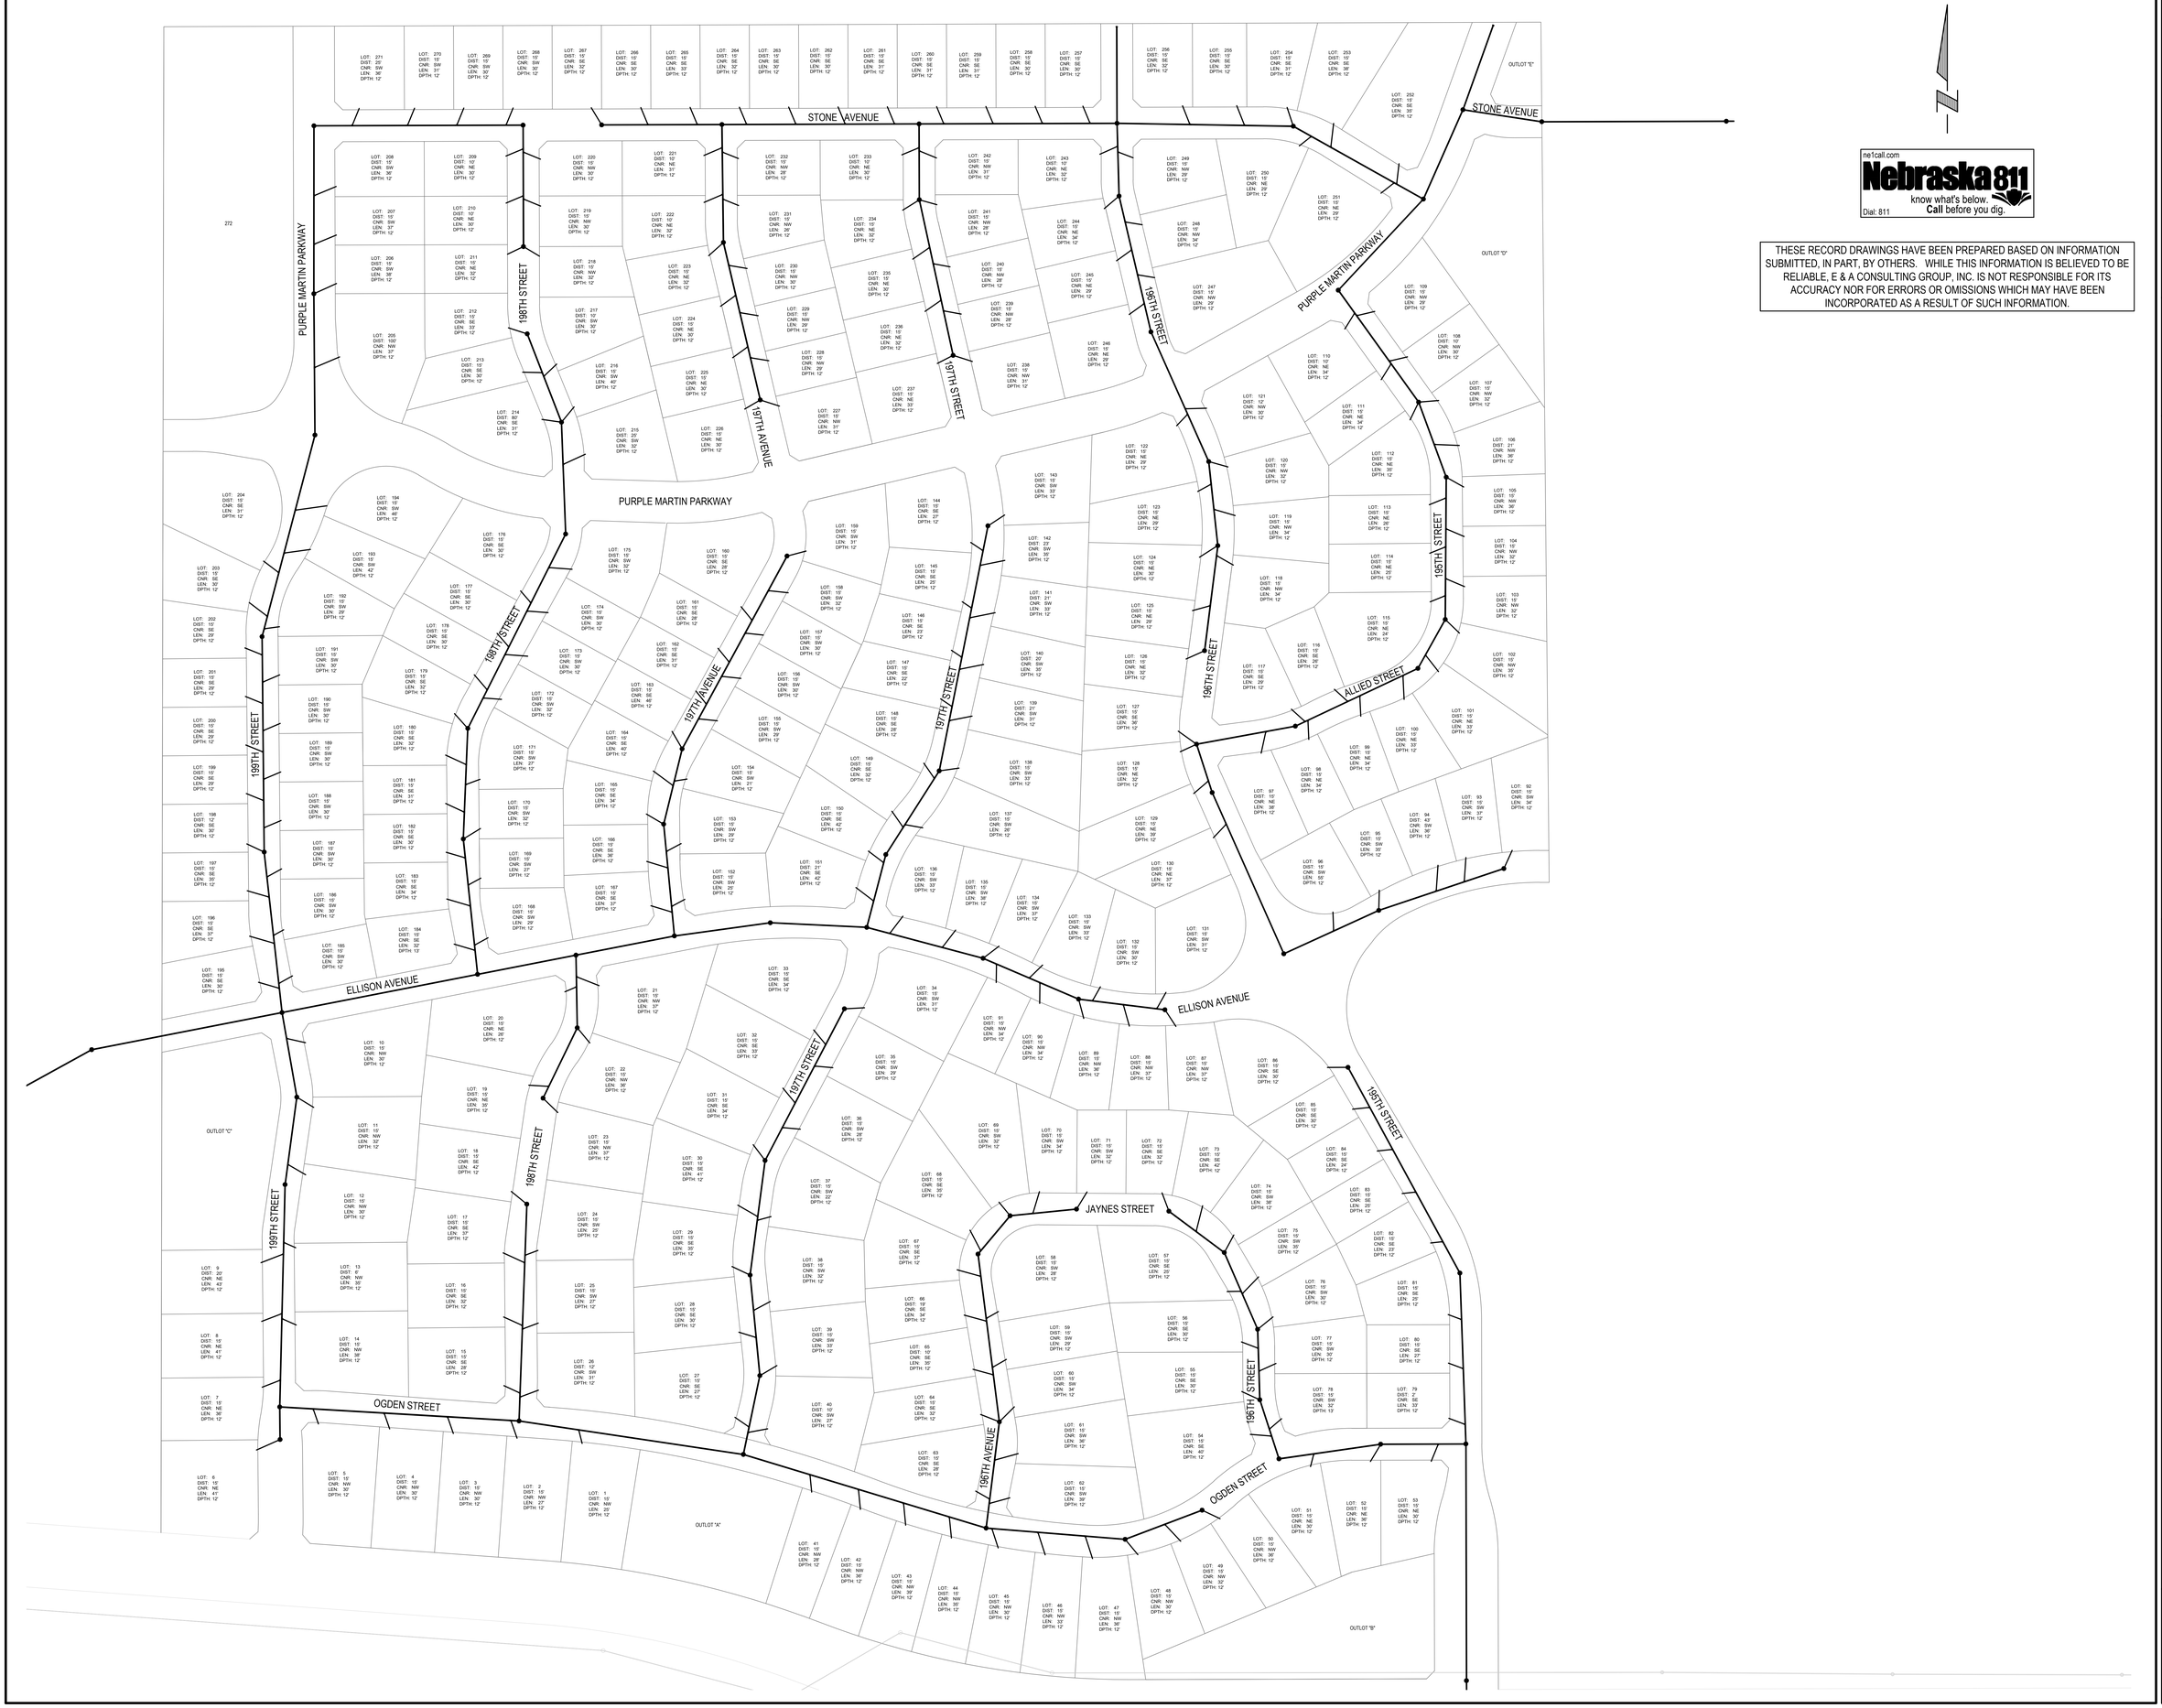

ne1call.com
Nebraska 811
know what's below.
Call before you dig.
Dial: 811

THESE RECORD DRAWINGS HAVE BEEN PREPARED BASED ON INFORMATION SUBMITTED, IN PART, BY OTHERS. WHILE THIS INFORMATION IS BELIEVED TO BE RELIABLE, E & A CONSULTING GROUP, INC. IS NOT RESPONSIBLE FOR ITS ACCURACY NOR FOR ERRORS OR OMISSIONS WHICH MAY HAVE BEEN INCORPORATED AS A RESULT OF SUCH INFORMATION.

E & A CONSULTING GROUP, INC.
Engineering • Planning • Environmental & Field Services
10909 Mill Valley Road, Suite 100 • Omaha, NE 68154
Phone: 402.895.9393 • Fax: 402.895.3599
www.eacg.com
E & A CONSULTING GROUP, INC.
Engineering Answers

AVANTE - LOTS 1 - 271
SANITARY SEWER - SECTION I
SID 620 - DOUGLAS COUNTY, NEBRASKA

SEWER STUB MAP

Proj No: P2021.130.000
Date: 12/12/2022
Drawn By: BDB REV2 HLB

Vista Xrfs:
8/30/2023 2:00 PM - C:\Sanitary Sewer Website\Avante - SID\AVANTE.dwg