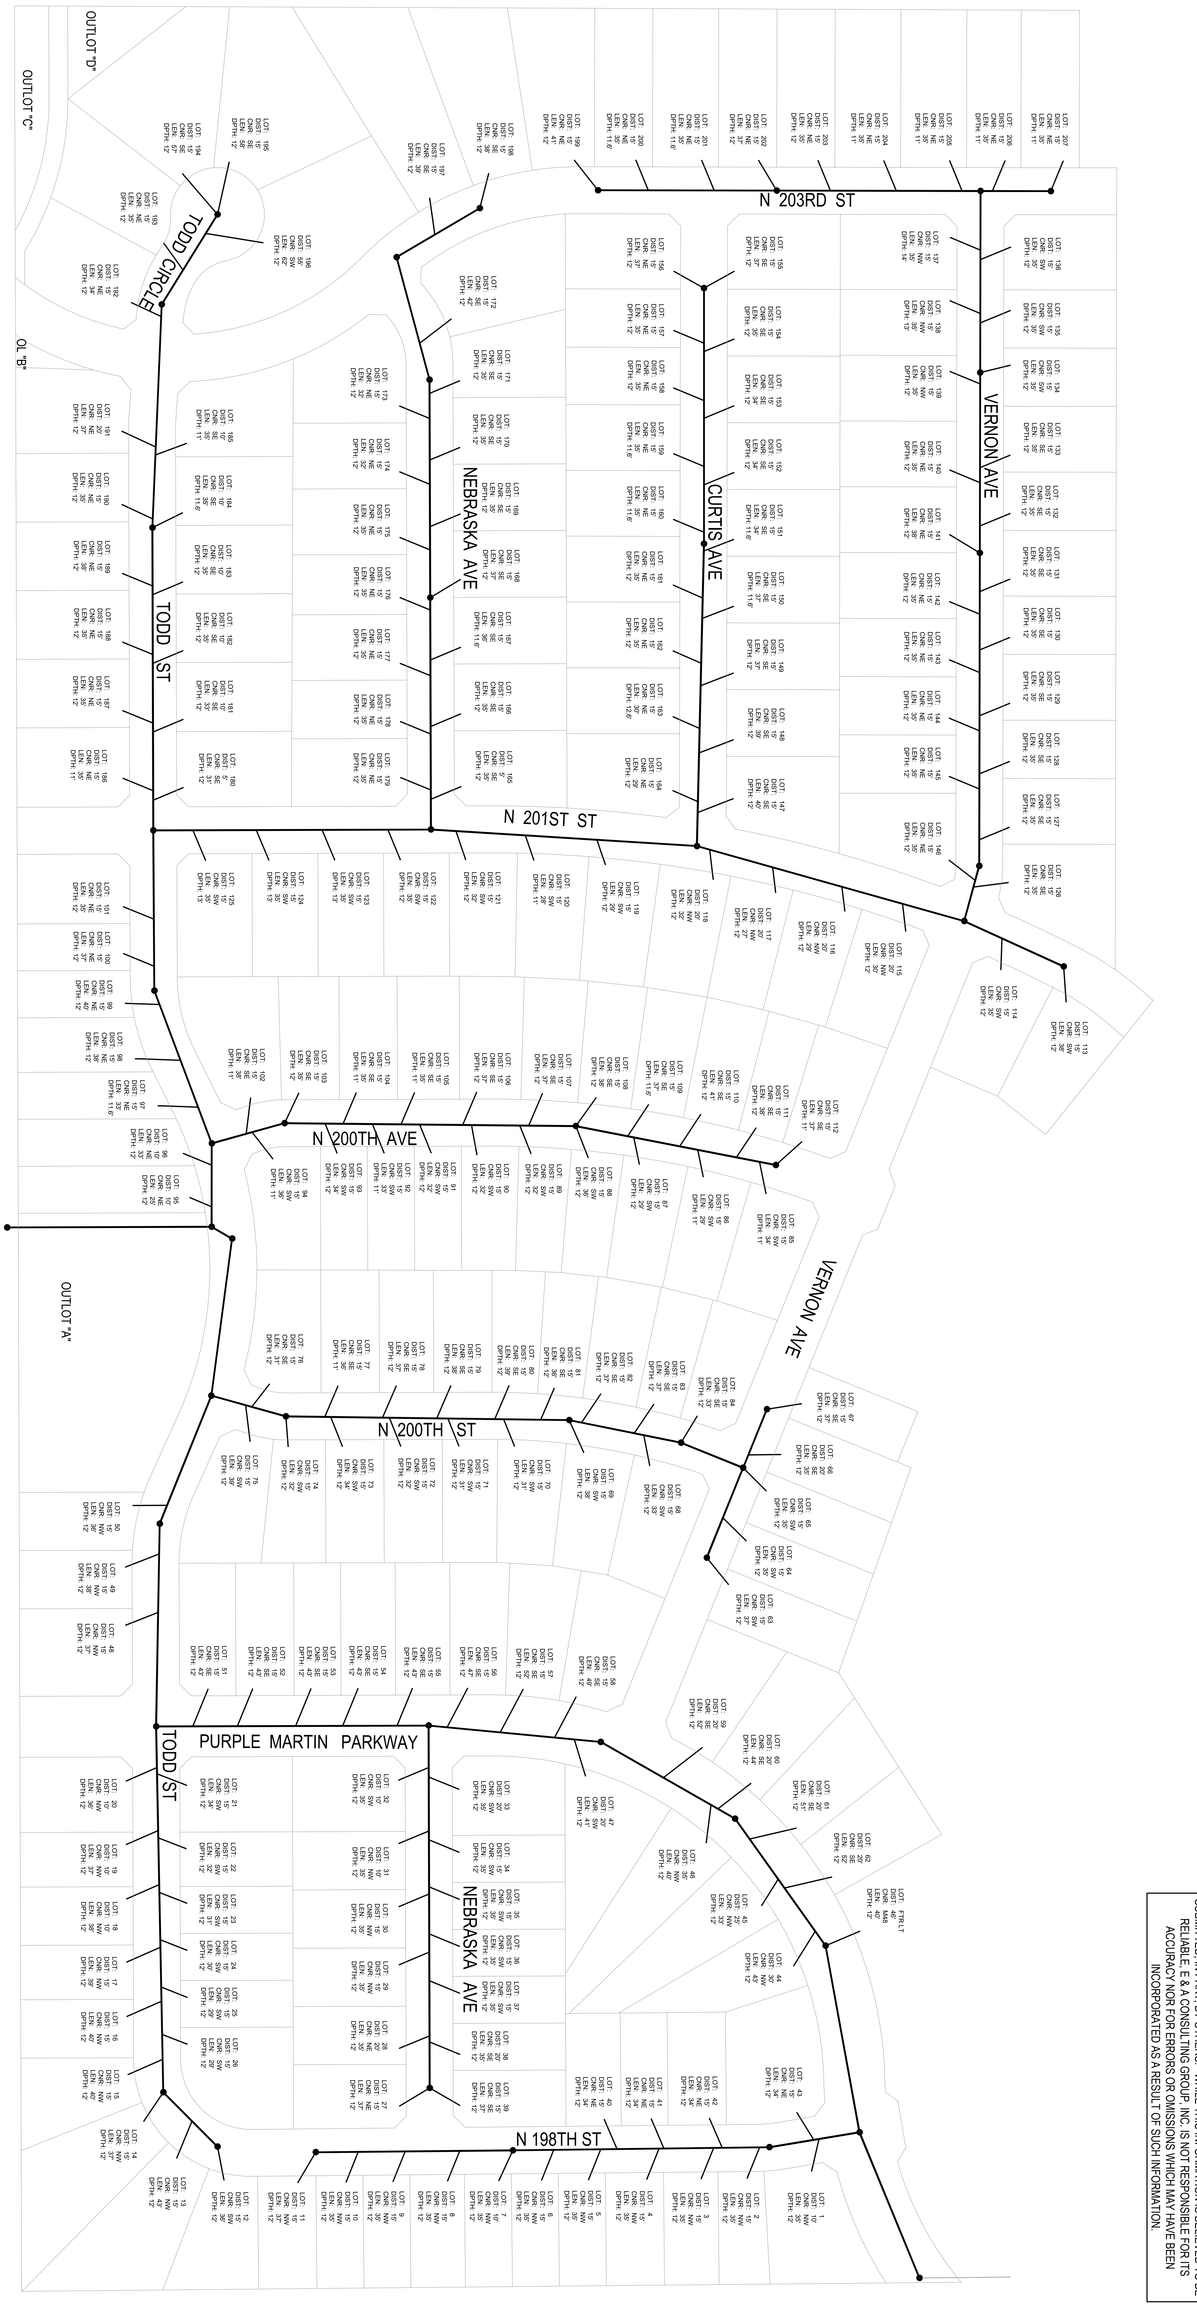


THESE RECORD DRAWINGS HAVE BEEN PREPARED BASED ON INFORMATION SUBMITTED IN PART BY OTHERS. WHILE THIS INFORMATION IS BELIEVED TO BE RELIABLE, E & A CONSULTING GROUP, INC. IS NOT RESPONSIBLE FOR ITS ACCURACY NOR FOR ERRORS OR OMISSIONS WHICH MAY HAVE BEEN INCORPORATED AS A RESULT OF SUCH INFORMATION.

Dial 811 or Call811.com
Nebraska811
Know what's below. Call before you dig.

Proj No:	2024.157.000
Date:	5/19/2026
Drawn By:	JTT

SEWER STUB MAP

INDIAN RIDGE - LOTS 1 - 207
SANITARY SEWER - SECTION I
SID 640 - DOUGLAS COUNTY, NEBRASKA

E & A CONSULTING GROUP, INC.
Engineering • Planning • Environmental & Field Services

10909 Mill Valley Road, Suite 100 • Omaha, NE. 68154
Phone: 402.895.4700 • Fax: 402.895.3599
www.eacg.com

Jared Tripp 5/20/2026 9:29 AM J:\Jared Tripp\Sewer Stubs\Indian Ridge\indian ridge.dwg