


THESE RECORD DRAWINGS HAVE BEEN PREPARED BASED ON INFORMATION SUBMITTED, IN PART, BY OTHERS. WHILE THIS INFORMATION IS BELIEVED TO BE RELIABLE, E & A CONSULTING GROUP, INC. IS NOT RESPONSIBLE FOR ITS ACCURACY NOR FOR ERRORS OR OMISSIONS WHICH MAY HAVE BEEN INCORPORATED AS A RESULT OF SUCH INFORMATION.

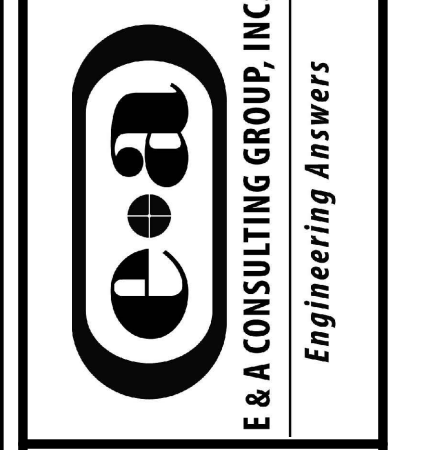

SEWER STUB MAP