


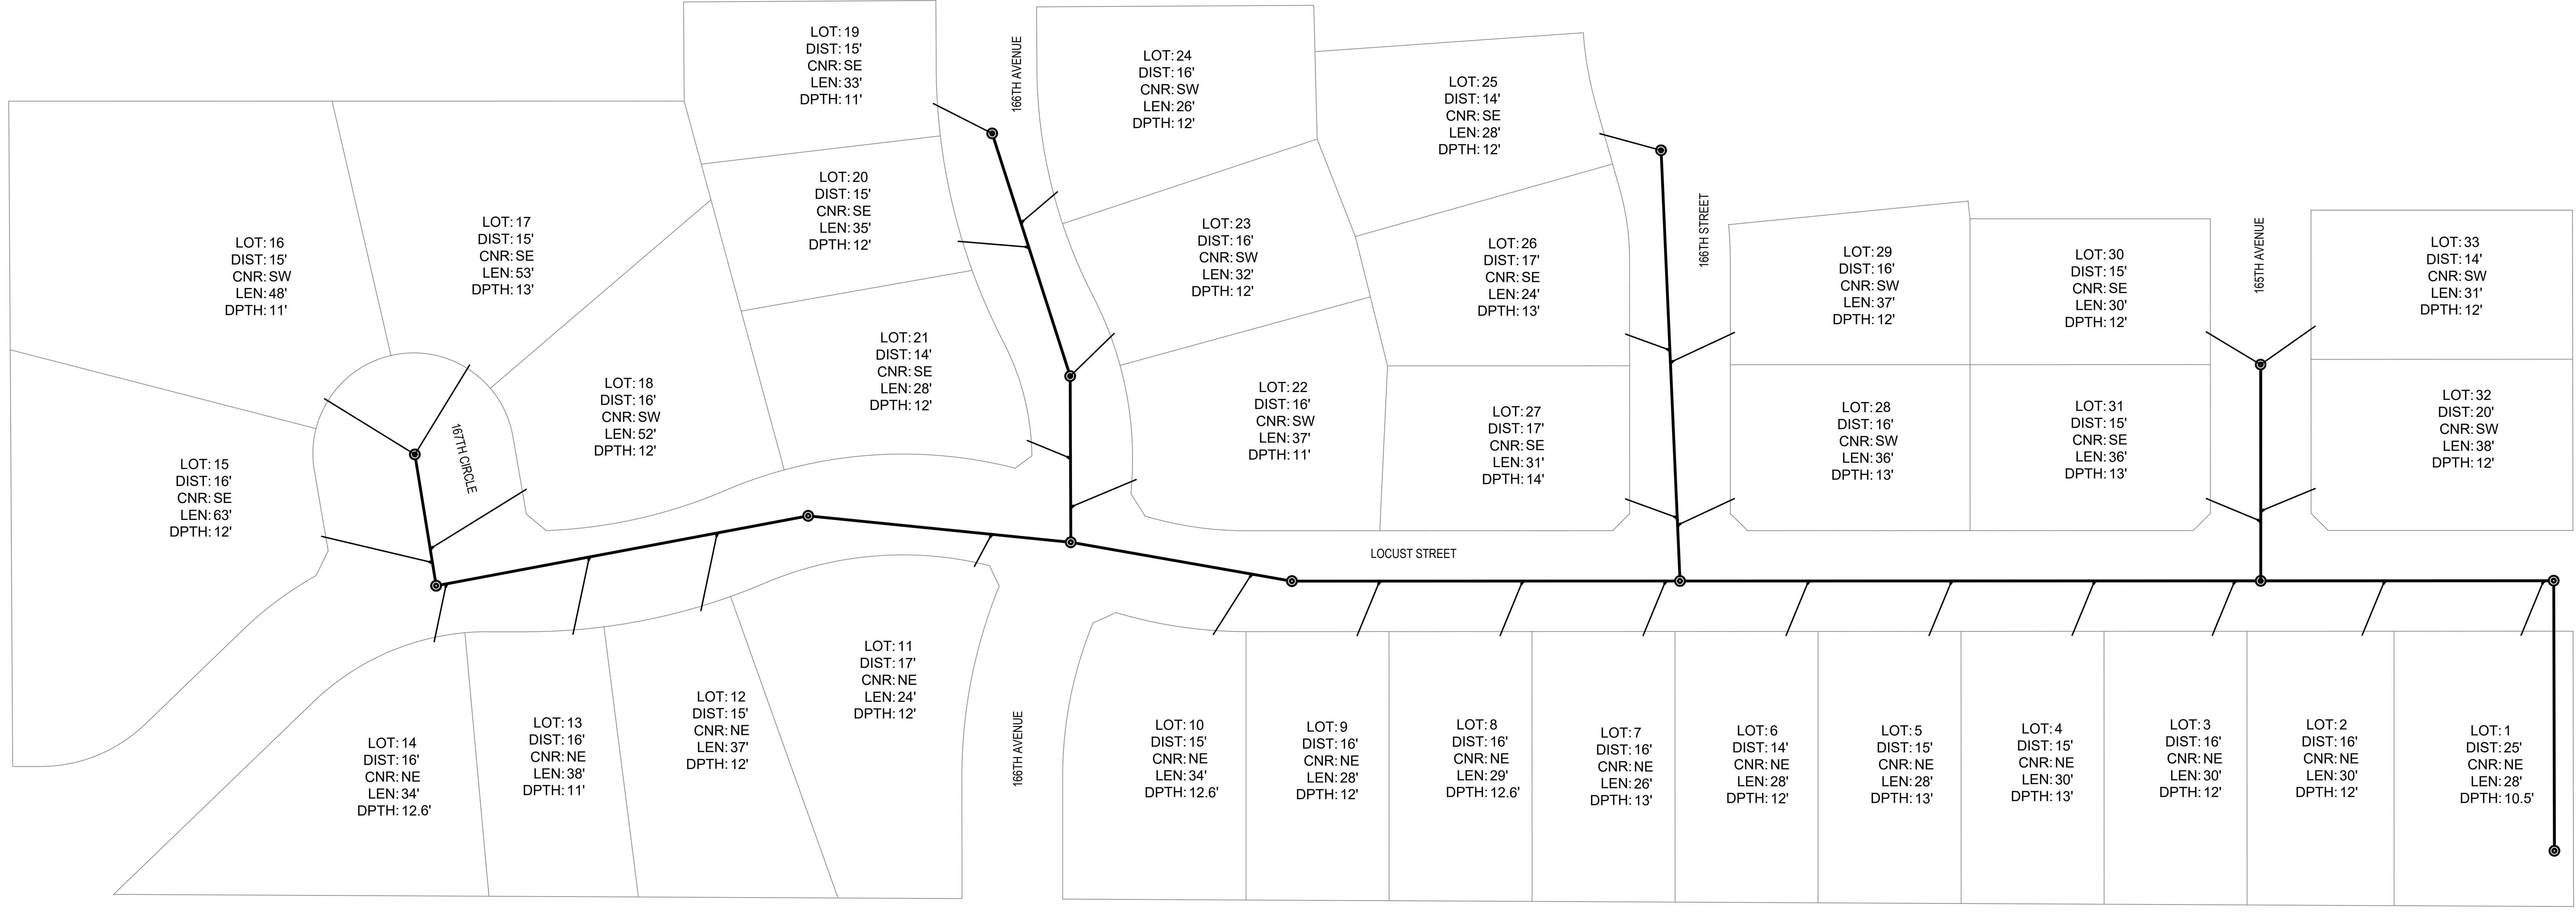

THESE RECORD DRAWINGS HAVE BEEN PREPARED BASED ON INFORMATION SUBMITTED, IN PART, BY OTHERS. WHILE THIS INFORMATION IS BELIEVED TO BE RELIABLE, E & A CONSULTING GROUP, INC. IS NOT RESPONSIBLE FOR ITS ACCURACY NOR FOR ERRORS OR OMISSIONS WHICH MAY HAVE BEEN INCORPORATED AS A RESULT OF SUCH INFORMATION.



E & A CONSULTING GROUP, INC.  
Engineering • Planning • Environmental & Field Services  
19300 JAWA Way Road, Suite 100 • Omaha, NE 68154  
Phone: 402.262.2266  
www.eagcg.com



SHADOW GLEN NORTH - LOTS 1 THRU 33  
SANITARY SEWER - SECTION I  
SID 497 - DOUGLAS COUNTY, NEBRASKA

# SEWER STUB MAP

Proj No: P2003-115-000  
Date: 02/08/2022  
Drawn By: BJS

8/8/2022 10:41 AM - C:\Users\jgwen\OneDrive\Documents\2022\02\08\2022\115\000.dwg